



# Suite 180 As Built Plan

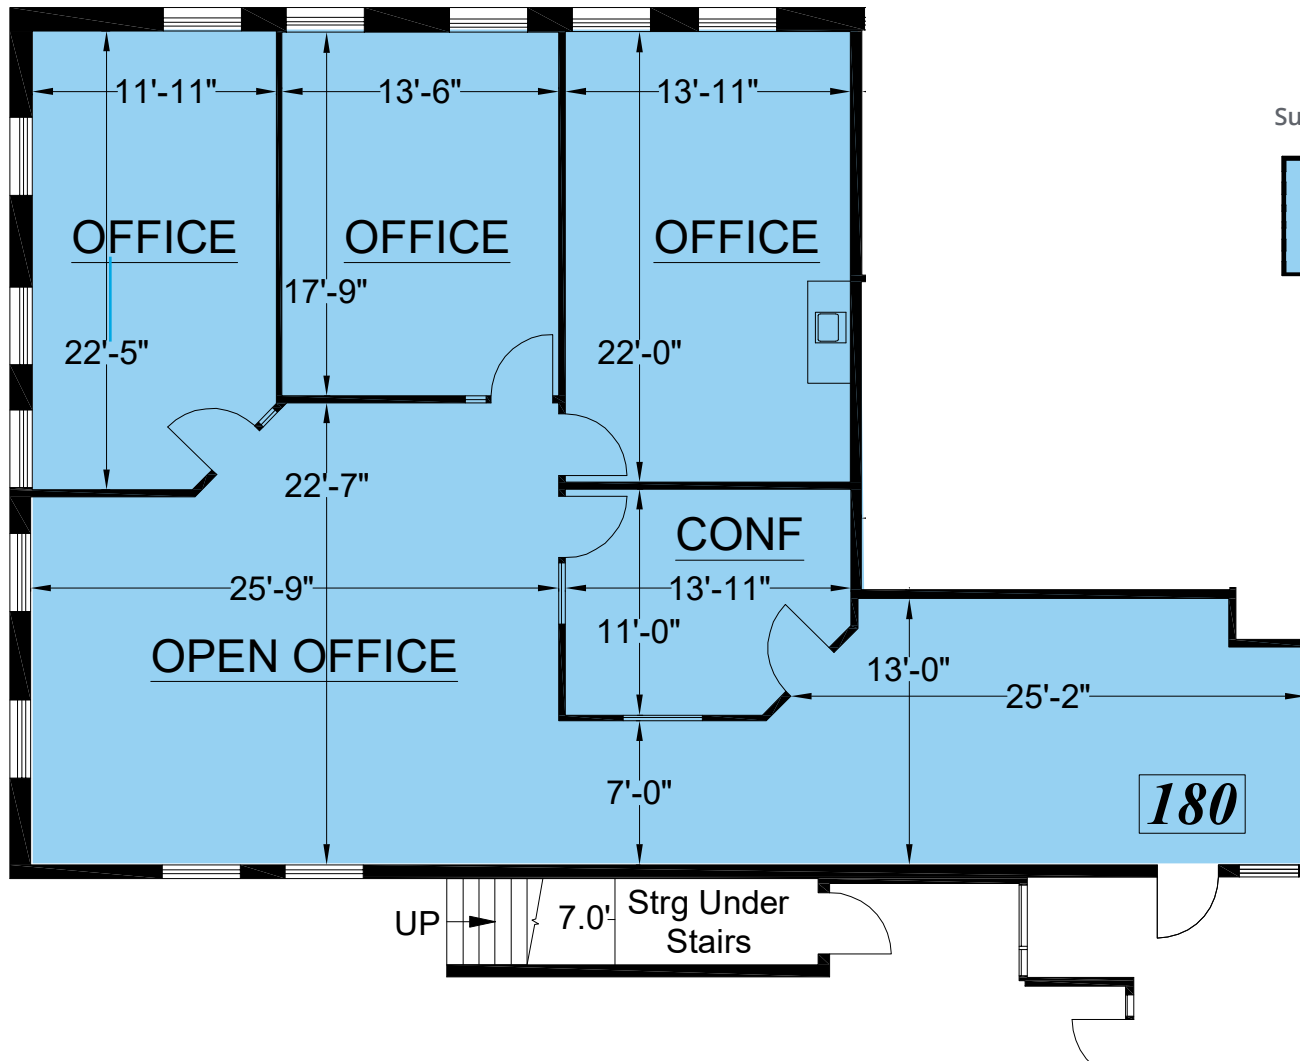

Suite Location

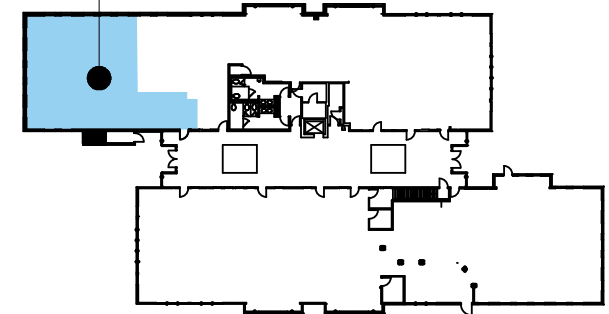

Key Plan Floor - 1


Suite 180  
±2,329 RSF

- 3 private offices
- Conference room
- Open office area

# Suite 180 Conceptual Floor Plan



Suite Location

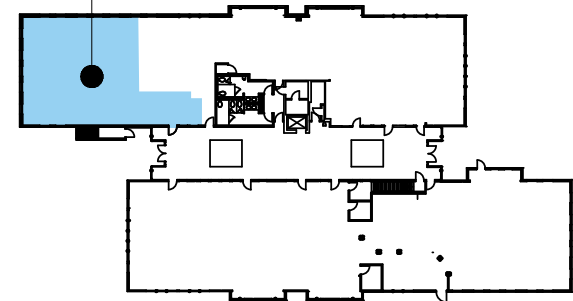

Key Plan Floor - 1