



Colliers International
1850 Mount Diablo Boulevard, Suite 200
Walnut Creek, CA 94596 | United States
www.colliers.com

LEASING AGENT

Matt Hurd
(925) 279-5567

matt.hurd@colliers.com

Scott Ellis
(925) 279-5575

scott.ellis@colliers.com

Salvio Pacheco Square

2151 Salvio Street
Concord, CA 94520

Second Floor

Owned & Managed by:

LeFever Mattson


Approximate Area Calculations
Subject To Verification:

5,262 rsf

As-built Plan To Be Verified

This information displayed while not guaranteed
has been secured by sources we believe to be
reliable. This information is subject to errors &
omissions. Any tenant should conduct their own
investigation.

Plan Revision - 11-5-22

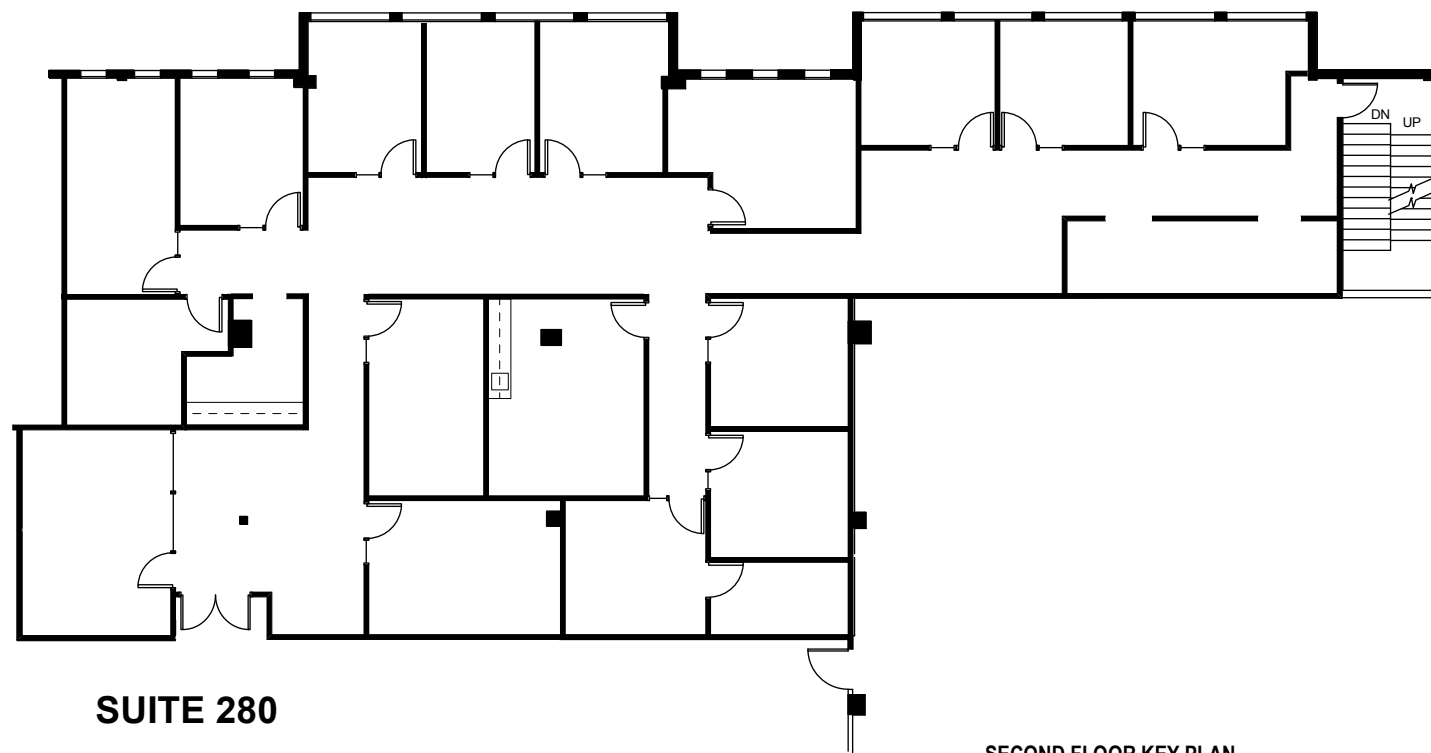

SECOND FLOOR KEY PLAN

