



Colliers International  
1850 Mount Diablo Boulevard, Suite 200  
Walnut Creek, CA 94596 | United States  
[www.colliers.com](http://www.colliers.com)

LEASING AGENT

**Scott Ellis**  
(925) 279-5575

[scott.ellis@colliers.com](mailto:scott.ellis@colliers.com)

**Matt Hurd**  
(925) 279-5567

[matt.hurd@colliers.com](mailto:matt.hurd@colliers.com)

## Buskirk Executive Center

2950 Buskirk Ave  
Walnut Creek, CA 94597

Second Floor

Owned and Managed by

**Cranbrook  
Group, Inc.**


Approximate Area Calculations  
Subject To Verification:

5,690 rsf


As-built Plan To Be Verified

This information displayed while not guaranteed has been secured by sources we believe to be reliable. This information is subject to errors & omissions. Any tenant should conduct their own investigation.

Plan Revision 6-24-24

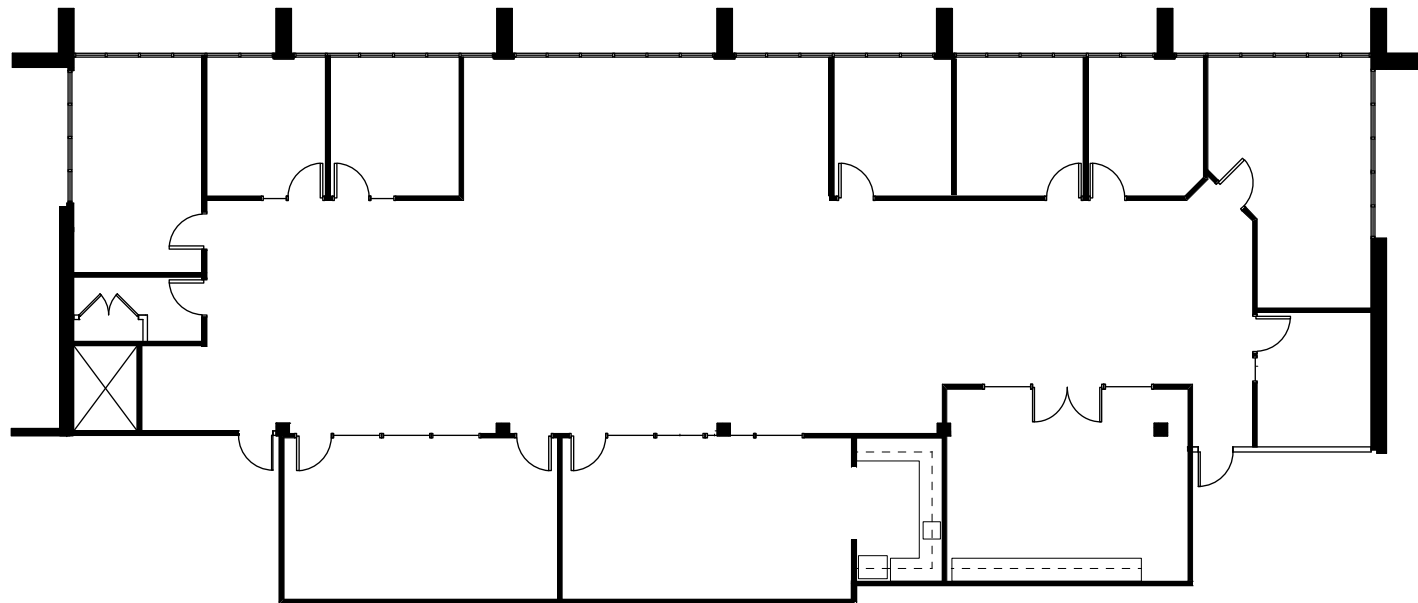

SUITE 225

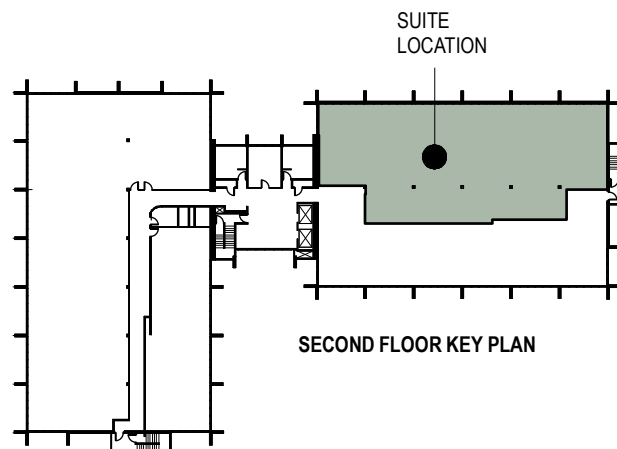

SECOND FLOOR KEY PLAN