


1410 Monument Blvd. | Concord, CA


Building One | First Floor

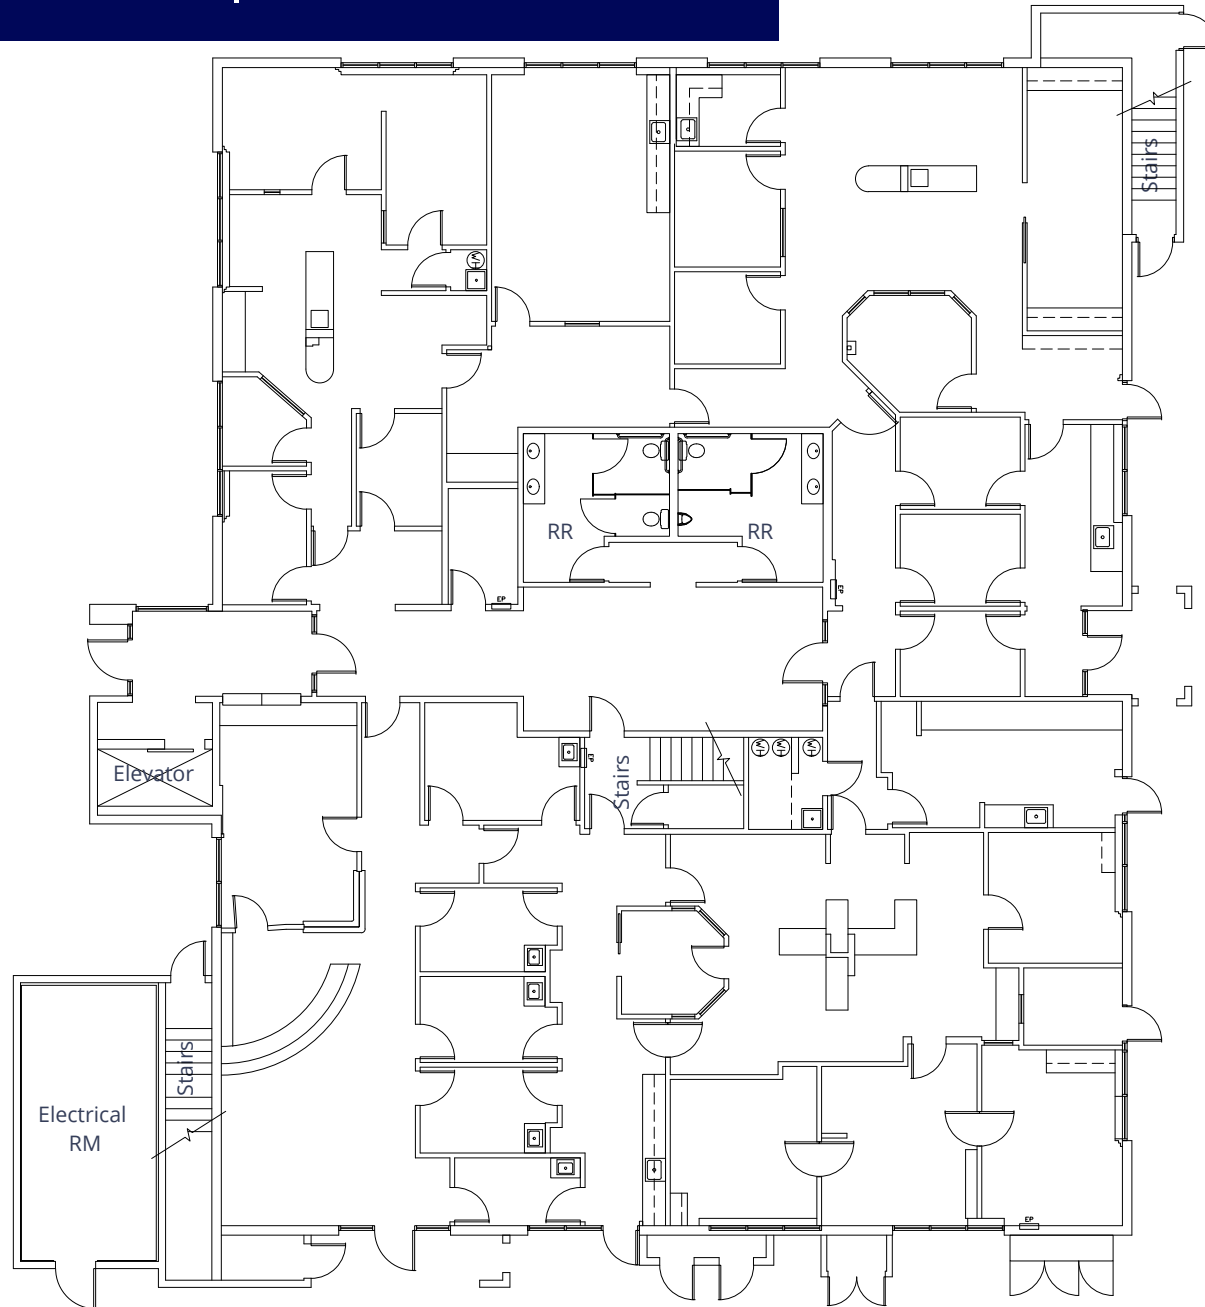

**Plan not to scale*

1410 Monument Blvd. | Concord, CA



Building One | Second Floor

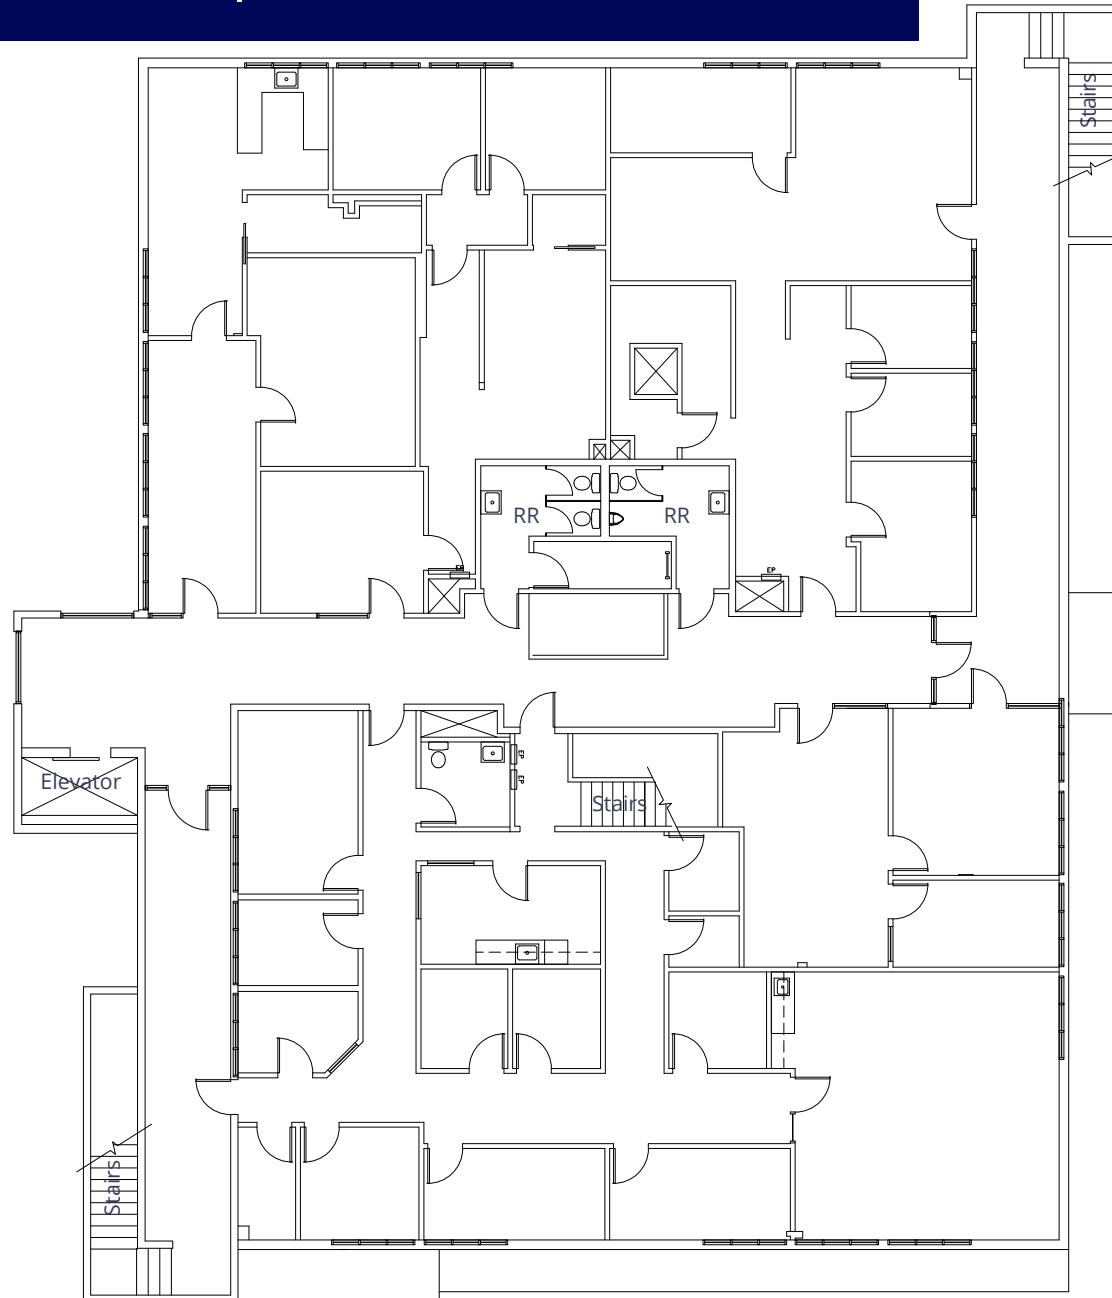

**Plan not to scale*

1410 Monument Blvd. | Concord, CA

Building Two | As Built Plan

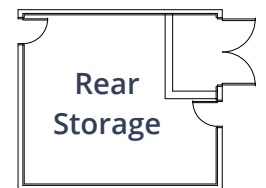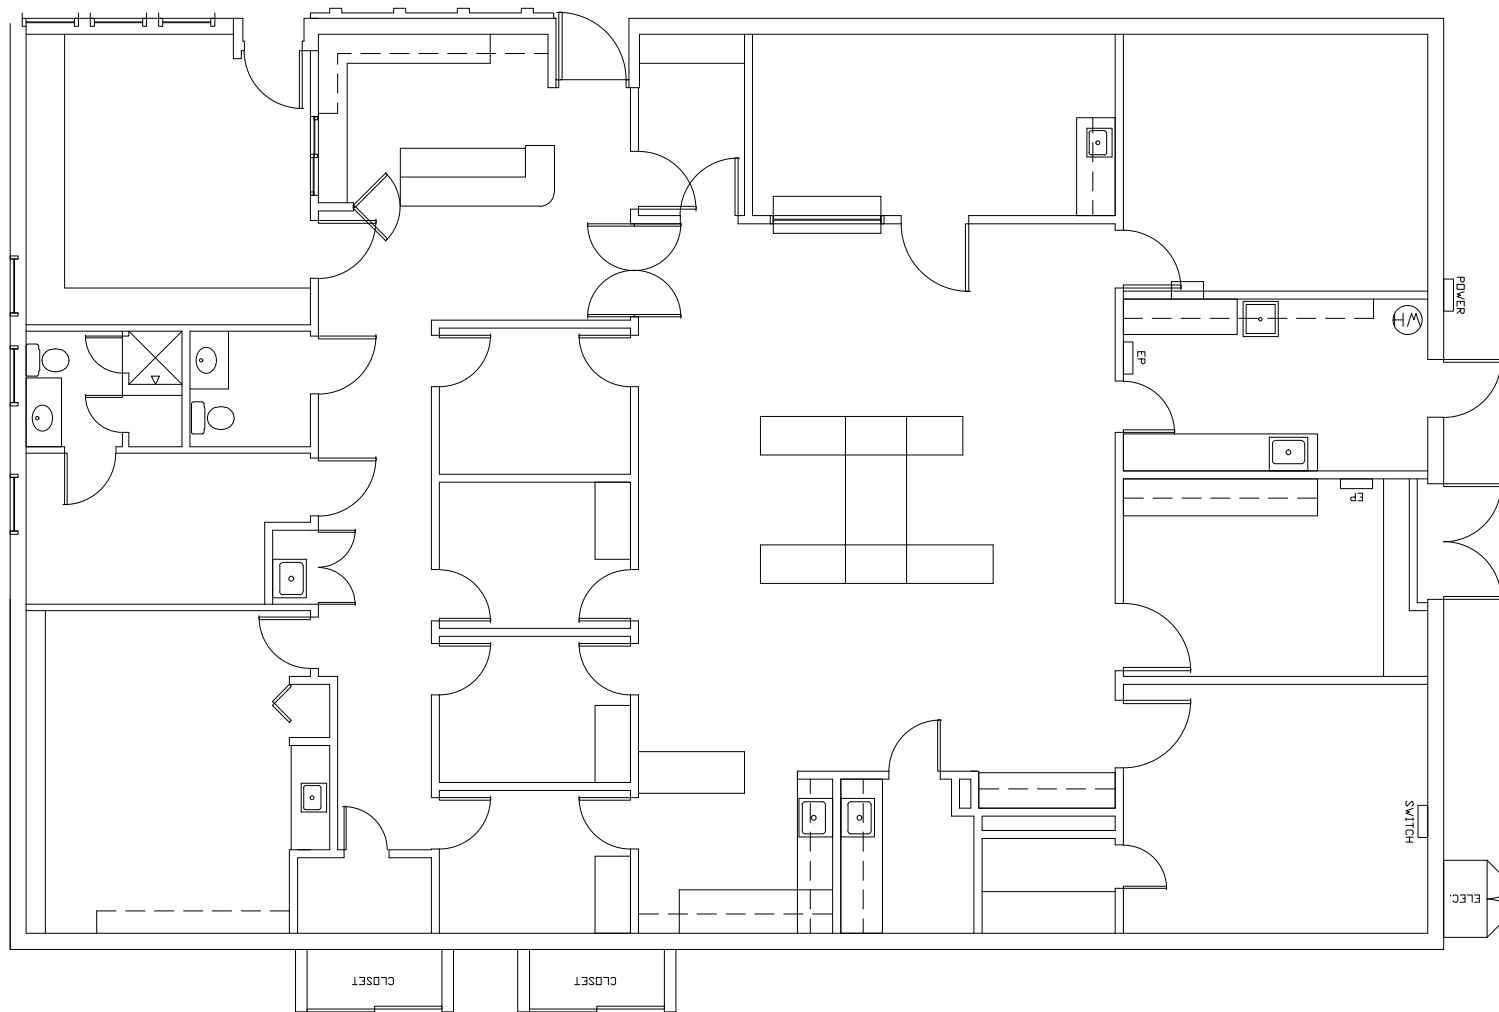

**Plan not to scale*